
## Customer Information Sheet

D3080-XX IF IN DOUBT - ASK NOT TO SCALE DRAWING No.: SHEET 2 OF 2 THIRD ANGLE PROJECTION ALL DIMENSIONS IN mm

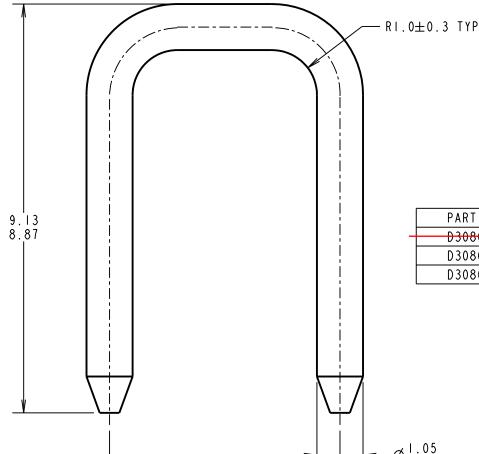

-5.08<sup>+0.50</sup>

**OBSOLETE** 

ORDER C	ODE:		
	[	3080	) - X X
			T
FINISH:			
<del>- 0   = -</del>	100%	MATTE T	<del>'   N -</del>
05 = (	GOLD	FLASH	
46 =	100%	BRIGHT	TIN

PART No.	FINISH			
D3080-01	2.54µ 100% MATTE TIN OVER 0.76µ NICKEL UNDERCOAT			
D3080-05	GOLD FLASH OVER 0.76µ NICKEL UNDERCOAT			
D3080-46	2.54μ 100% BRIGHT TIN OVER 0.76μ NICKEL UNDERCOAT			

1		1 1	I I	Ī		
	SB	12	18.12.12	11891		
	NAME	188.	DATE	C/NOTE		
	APPROVED: S.BENNETT					
	CHECKED: S.FLOWER					
	DRAWN: C. HANSEN					
	CUSTOMER REF.:					
	ASSEN	MBLY (	ORG:			
	D3086-XX					

www.harwin.com technical@harwin.com THIS DRAWING AND ANY INFORMATION OR DESCRIPTIVE MATTER SET OUT HEREON ARE CONFIDENTIAL AND COPYRIGHT PROPERTY OF THE HARWIN GROUP AND MUST NOT BE DISCLOSED, LOANED, COPIED OR USED FOR MANUFACTURING, TENDERING OR FOR ANY OTHER PURPOSE WITHOUT THEIR WRITTEN PERMISSION.

**TOLERANCES** X. = ±1mm  $X.X = \pm 0.25 mm$  $X.XX = \pm 0.10$ mm

 $X.XXX = \pm 0.01$ mm ANGLES = ±5° UNLESS STATED

MATERIAL: BRASS C2600

S/AREA:

FINISH: SEE ABOVE mm<sup>2</sup> TITLE:

Imm SHORTING LINK

DRAWING NUMBER:

D3080-XX

SHT 2 OF<sub>2</sub>